


UNIT #2 FIRST FLOOR PLAN  
 1/8" = 1'-0"

LEGEND


- ▲ MAIN ENTRY
- △ SECONDARY ENTRY
- ▨ EXCLUSIVE RIGHT TO USE BY UNIT #1
- ▩ EXCLUSIVE RIGHT TO USE BY UNIT #2
- ◻ COMMON TO ALL

GRAPHIC SCALE

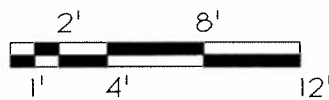

UNIT #2 BASEMENT PLAN  
 1/8" = 1'-0"

I certify that these plans show the unit designation of UNIT #2 of the 27 RUTLAND AVENUE CONDOMINIUM being conveyed and of the immediately adjoining units, and that they fully and accurately depict its layout, location, dimensions, approximate area, main entrances, and immediate common area to which it has access, as built. I certify that these plans were prepared in conformity with the rules and regulations of the Registers of Deed of the Commonwealth of Massachusetts as amended January 1, 1976.

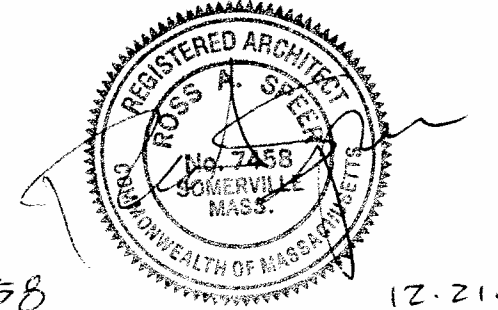




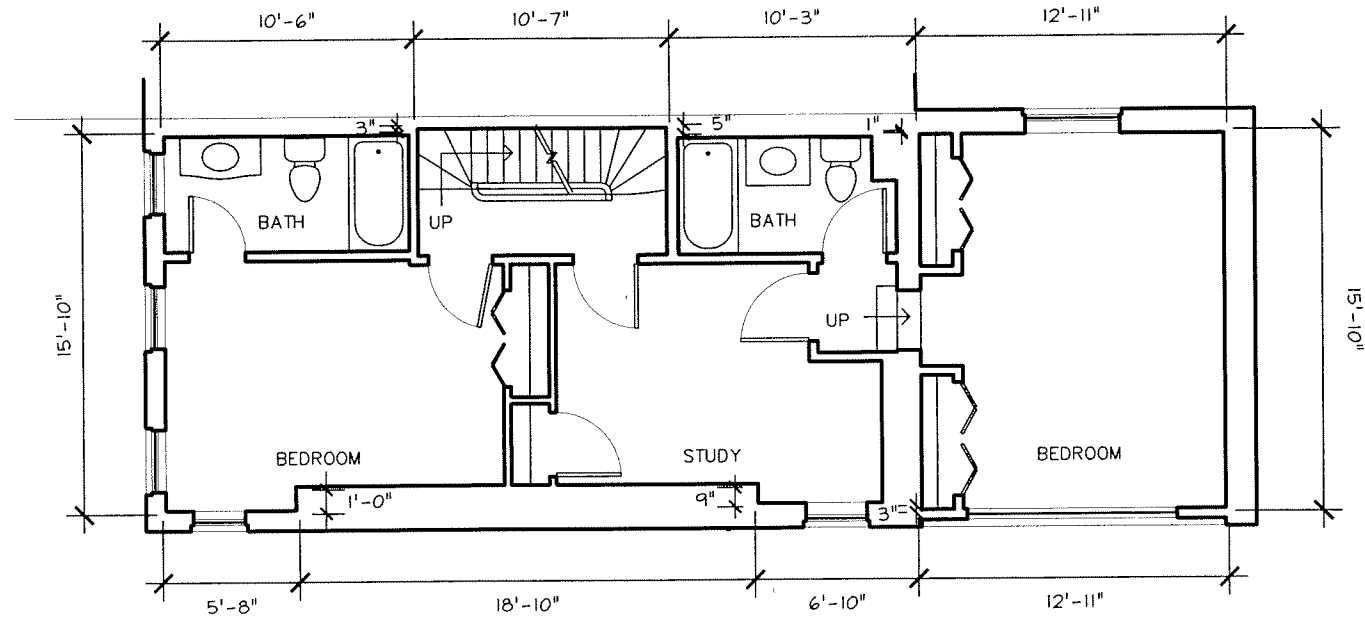
# 7458

12.21.06





LEGEND

-  MAIN ENTRY
-  SECONDARY ENTRY
-  EXCLUSIVE RIGHT TO USE BY UNIT #2




UNIT #2 THIRD FLOOR PLAN  
1/8" = 1'-0"

GRAPHIC SCALE

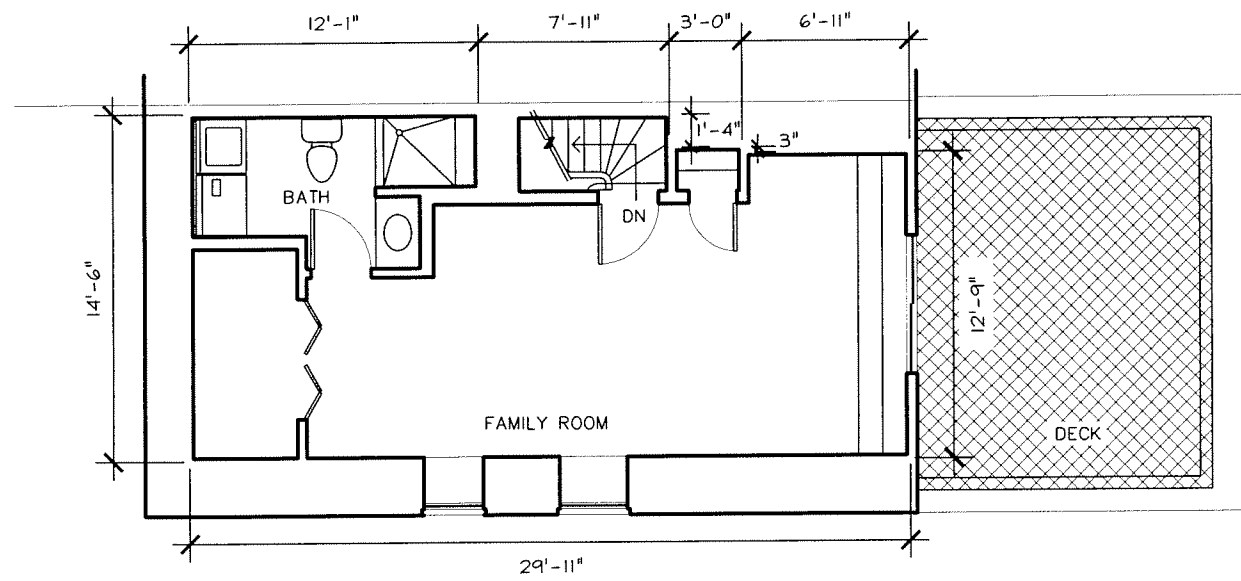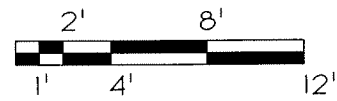

UNIT #2 SECOND FLOOR PLAN  
1/8" = 1'-0"

I certify that these plans show the designation of UNIT #2 of the RUTLAND AVENUE CONDOMINIUM conveyed and of the immediate adjoining units, and that they accurately depict its layout, lot dimensions, approximate area, entrances, and immediate common to which it has access, as built. I certify that these plans were prepared in conformity with the rules and regulations of the Registers of the Commonwealth of Massachusetts amended January 1, 1976.

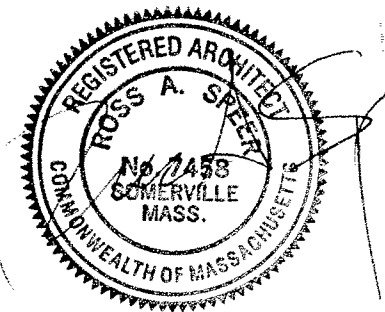

#7458